


SOUTH ELEVATION

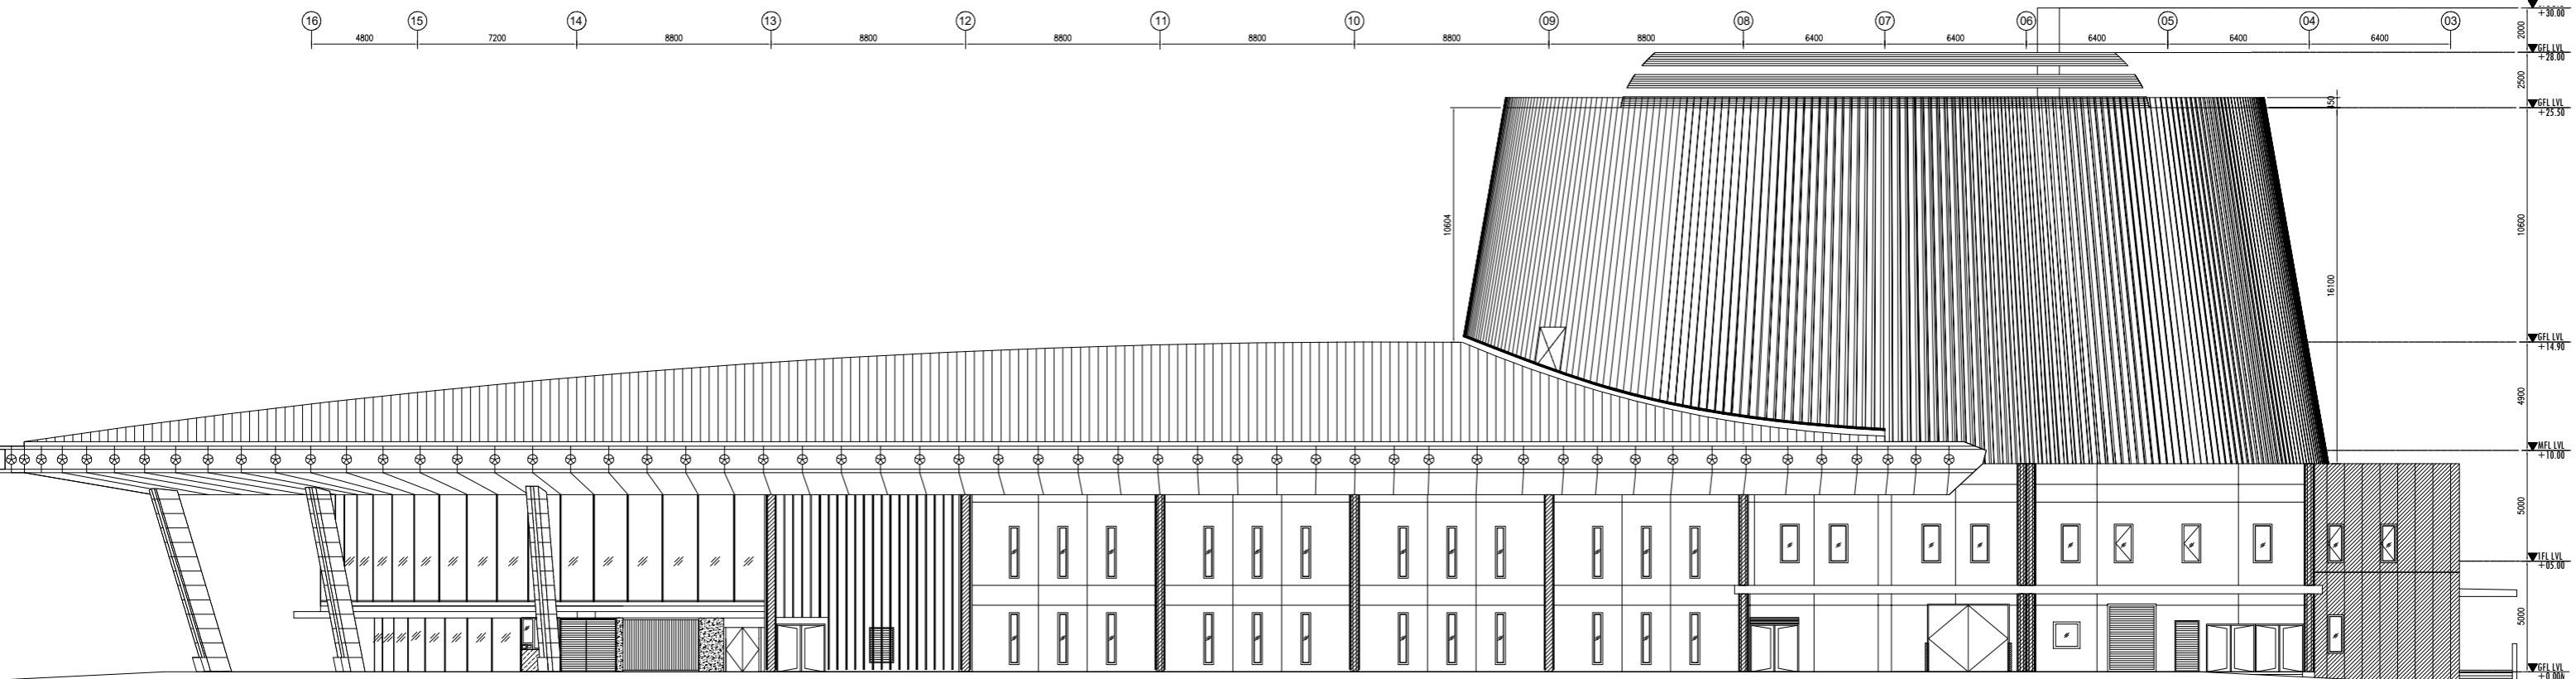

NORTH ELEVATION

PROJECT TITLE
THE PROJECT FOR CONSTRUCTION OF THE INTERNATIONAL COOPERATION AND CONVENTION CENTER IN VARANASI

GENERAL NOTE

NO	DATE	DESCRIPTION

CLIENT
THE MINISTRY OF HOUSING & URBAN AFFAIRS

SCALE
1:100 (A1)
 DATE
MAR. 2021

DWG NAME
NORTH & SOUTH ELEVATION
 DESIGNED BY : **ORIENTAL CONSULTANTS GLOBAL CO.LTD. & NIKKEN SEKKEI**
 CONTRACTOR : **FUJITA CORPORATION**

DWG TITLE
AS BUILT
 DWG NO
A0-10